




1 TYPICAL GRADUATE/DORM ROOM T&B BLOW-UP PLAN
SCALE 1:50 MTS

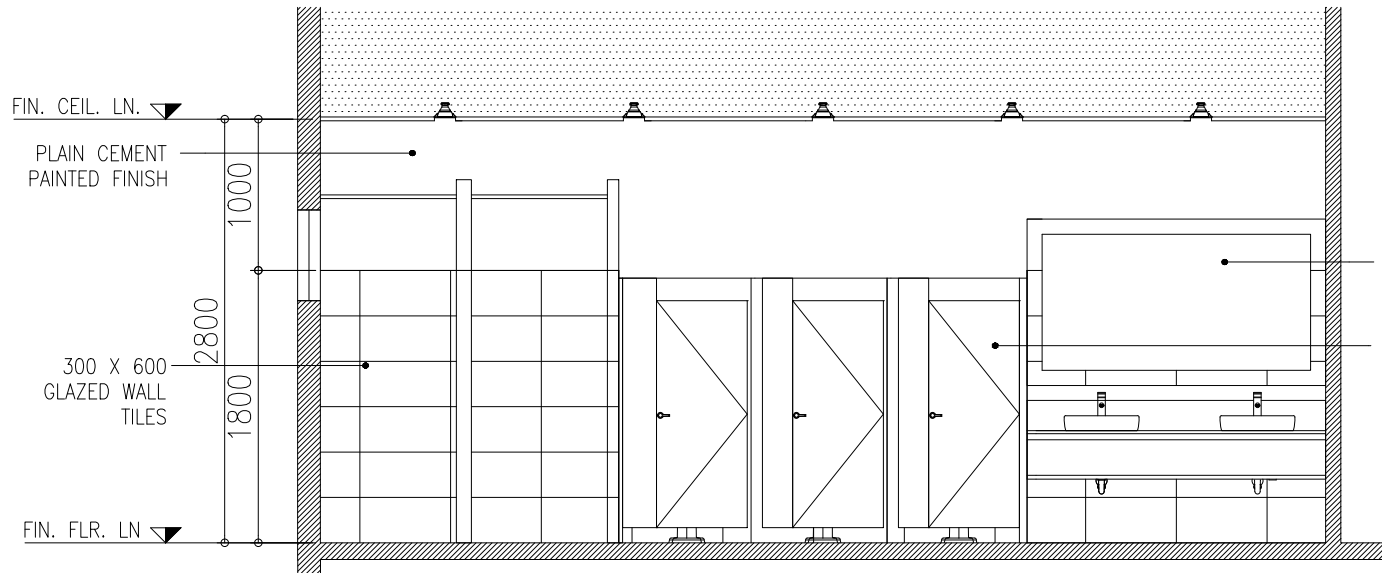


3 SECTION 2b
SCALE 1:50 MTS

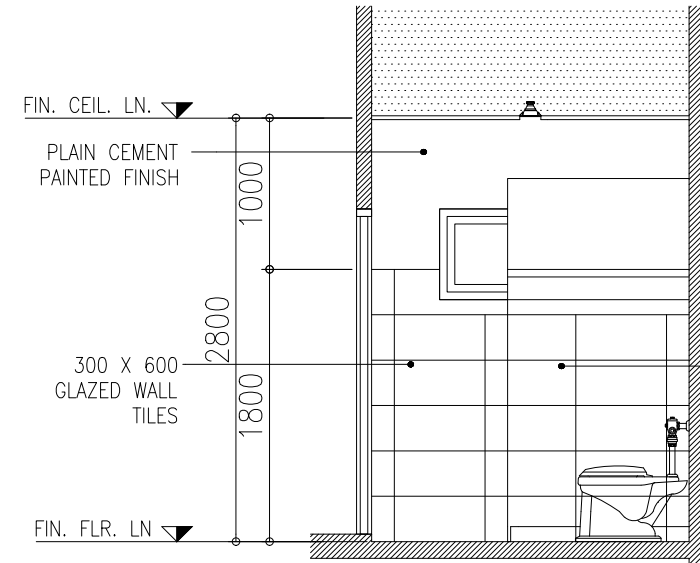

2 SECTION 1b
SCALE 1:50 MTS

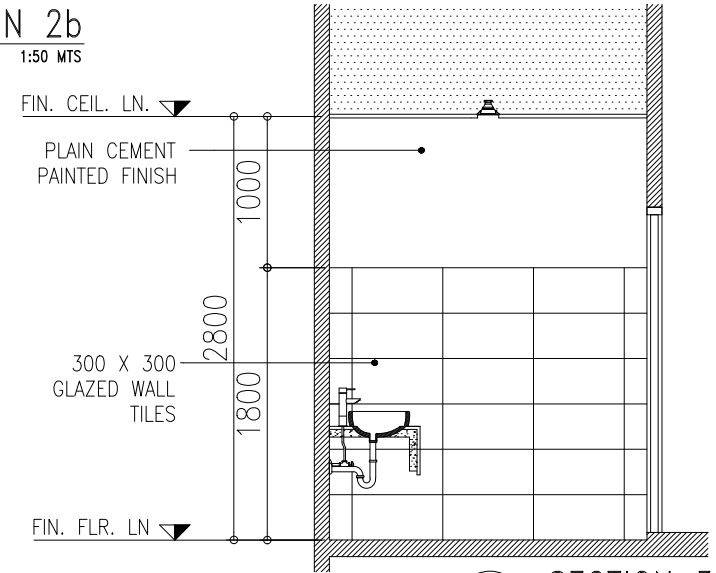

4 SECTION 3b
SCALE 1:50 MTS

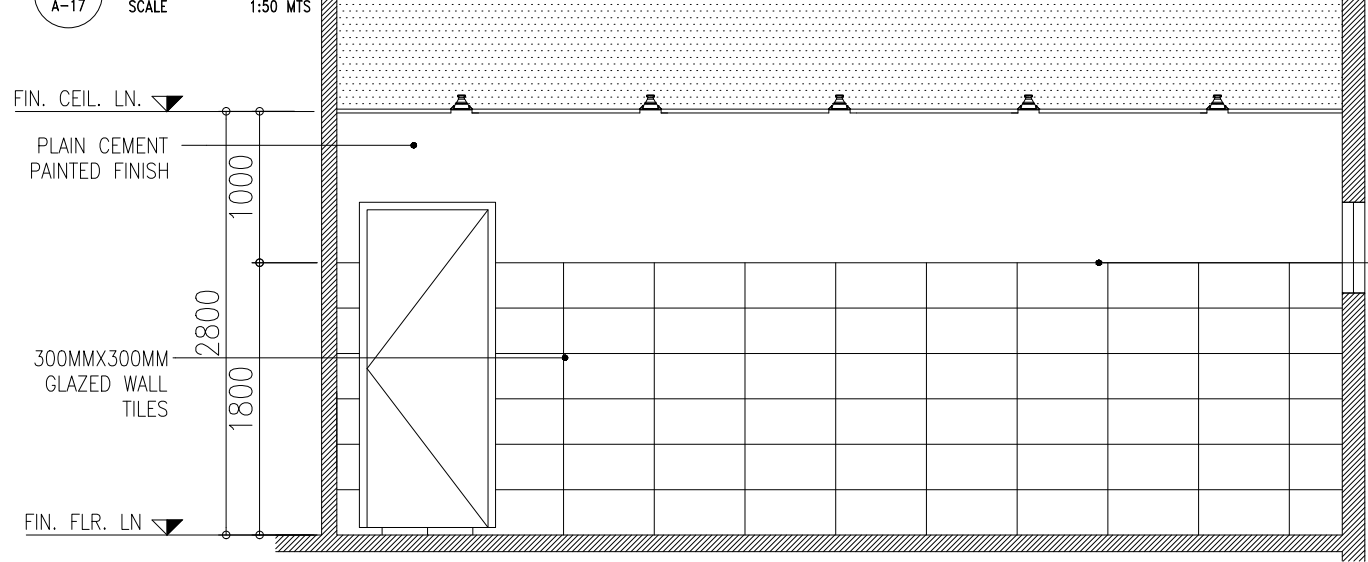

4 SECTION 4b
SCALE 1:50 MTS

- NOTES:
1. ALL DIMENSION ARE IN METERS AND MILLIMETERS UNLESS SHOWN OTHERWISE.
 2. DRAWINGS ARE NOT TO BE SCALED, THE STATED DIMENSIONS ONLY ARE TO BE TAKEN.
 3. ANY INCONSISTENCY OR DISCREPANCY IS TO BE BROUGHT TO THE ATTENTION OF & RESOLVED BY THE ENGINEER BEFORE THE WORK IS PUT IN HAND.
 4. DRAWINGS ARE TO BE READ IN CONJUNCTION WITH THE RELEVANT ARCHITECTURAL AND SERVICES DRAWINGS.



PREPARED BY
IAPOA No.:
REG No.:
REG DATE:
TIN No.:

PTR No.:
REG VALID:
ISSUED:

REPUBLIC ACT 9266
DRAWINGS AND SPECIFICATIONS AND OTHER CONTRACT DOCUMENTS DULY SIGNED, STAMPED OR SEALED, AS INSTRUMENTS OF SERVICE, ARE THE INTELLECTUAL PROPERTY AND DOCUMENT OF THE ARCHITECT. WHETHER THE OBJECT FOR WHICH THEY ARE MADE IS EXECUTED OR NOT, IT SHALL BE UNLAWFUL FOR ANY PERSON TO DUPLICATE OR TO MAKE COPIES OF SAID DOCUMENTS FOR USE IN THE REPETITION OF AND FOR OTHER PROJECTS OR BUILDINGS, WHETHER EXECUTED PARTY OR IN WHOLE, WITHOUT THE WRITTEN CONSENT OF ARCHITECT OR AUTHOR OF SAID DOCUMENT.

PROJECT TITLE
DESIGNED FOR:
CHECKED BY:
REVIEWED BY:
CONFORMED BY:
RECOMMENDING APPROVAL:
APPROVED BY:

CONSTRUCTION OF MEN'S FOUR (4) STOREY DORMITORY BUILDING PHASE 1 (AS-BUILT)

ENGR. CLINTON VAL BRIGOLA
PROJECT CONTROL ENGINEER

ENGR. CARLITO A. ELLAZAR
PROJECT ENGINEER

REYNALDO B. GARNACE, DA
CAD, ADMINISTRATION

DR. EVELYN B. AGUIRRE
VP for ADMINISTRATION & FINANCE

JUDE A. DUARTE, DPA
UNIVERSITY PRESIDENT


LOCATION: TACLOBAN CITY, LEYTE




SHEET CONTENTS:
SHEET NO./

TOILET DETAILS

A
15 16

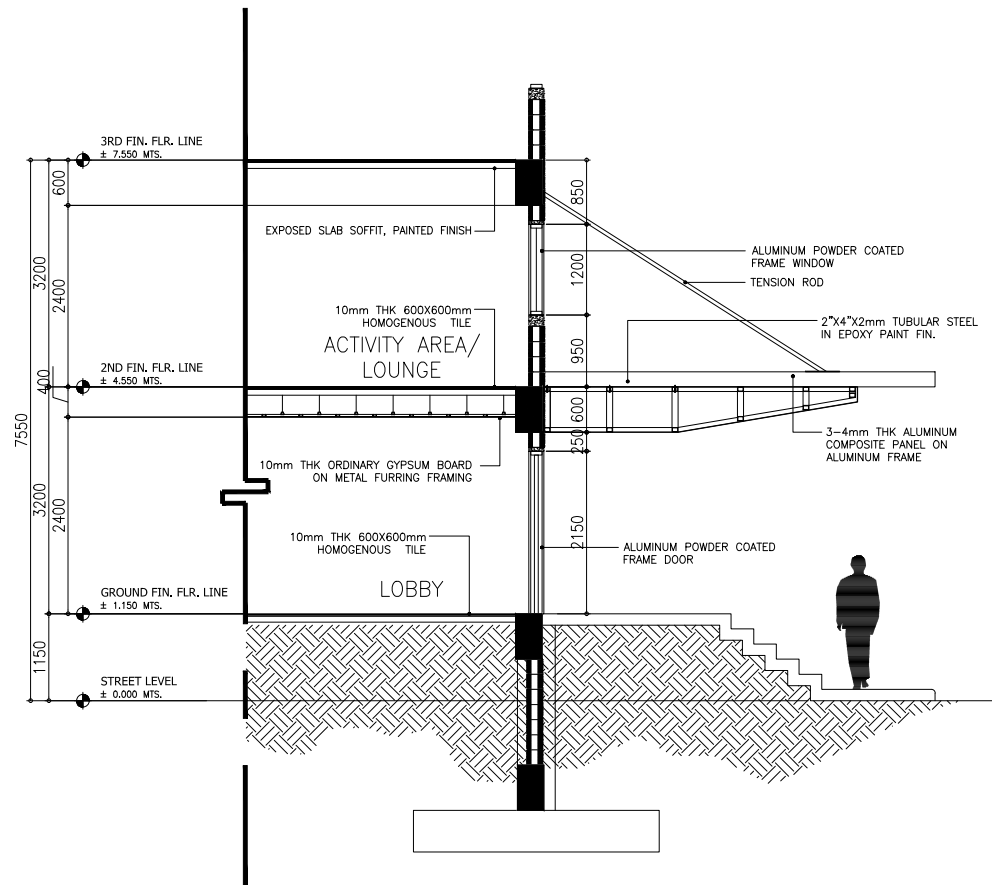

1 BAY SECTION 1
A-17.1 SCALE 1:100 MTS

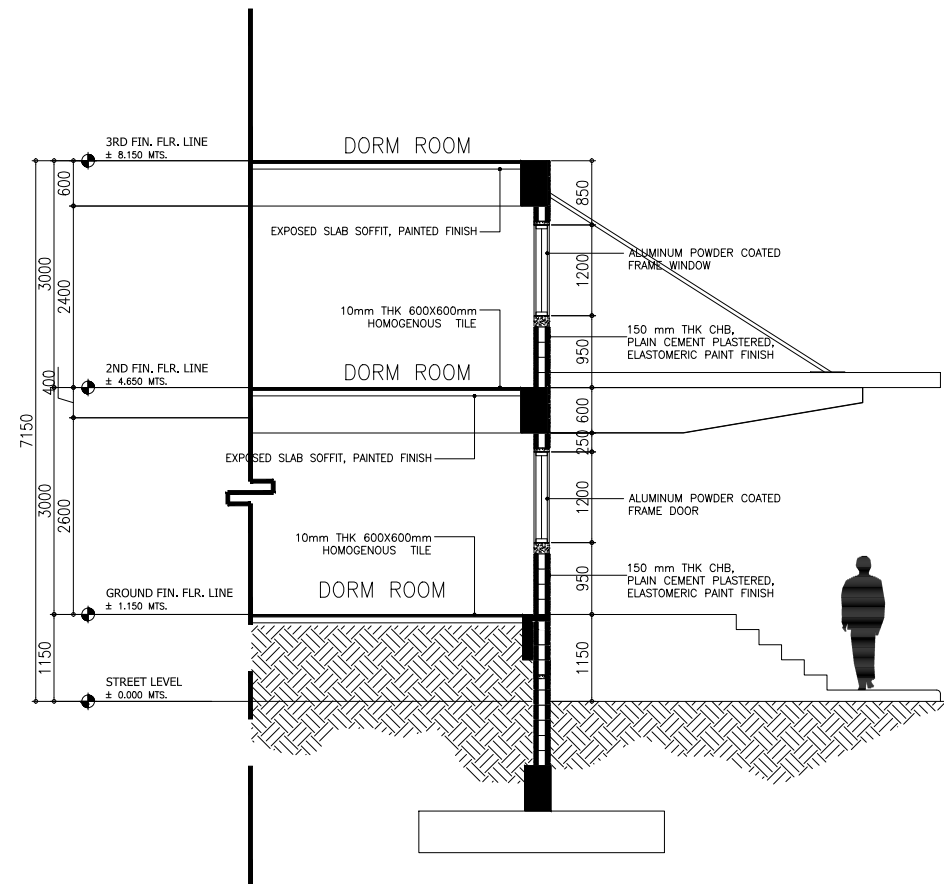

1 BAY SECTION 2
A-17.1 SCALE 1:100 MTS

- NOTES:
1. ALL DIMENSION ARE IN METERS AND MILLIMETERS UNLESS SHOWN OTHERWISE.
 2. DRAWINGS ARE NOT TO BE SCALED, THE STATED DIMENSIONS ONLY ARE TO BE TAKEN.
 3. ANY INCONSISTENCY OR DISCREPANCY IS TO BE BROUGHT TO THE ATTENTION OF & RESOLVED BY THE ENGINEER BEFORE THE WORK IS PUT IN HAND.
 4. DRAWINGS ARE TO BE READ IN CONJUNCTION WITH THE RELEVANT ARCHITECTURAL AND SERVICES DRAWINGS.

<p>RIGHTY A'S CONSTRUCTION & HARDWARE SUPPLY Block 15 Lot 12-13 Block E3 Lower Naga-Tuba, Tacloban Contact No.: 09173156192/09177269444 Email Add: mighty_a_com@yahoo.com/engr_alquim@yahoo</p>	<p>PREPARED BY</p>	<p>REPUBLIC ACT 9266</p> <p><small>DRAWINGS AND SPECIFICATIONS AND OTHER CONTRACT DOCUMENTS DULY SIGNED, STAMPED OR SEALED, AS INSTRUMENTS OF SERVICE, ARE THE INTELLECTUAL PROPERTY AND DOCUMENT OF THE ARCHITECT. WHETHER THE OBJECT FOR WHICH THEY ARE MADE IS EXECUTED OR NOT, IT SHALL BE UNLAWFUL FOR ANY PERSON TO DUPLICATE OR TO MAKE COPIES OF SAID DOCUMENTS FOR USE IN THE REPETITION OF AND FOR OTHER PROJECTS OR BUILDINGS, WHETHER EXECUTED PARTY OR IN WHOLE, WITHOUT THE WRITTEN CONSENT OF ARCHITECT OR AUTHOR OF SAID DOCUMENT.</small></p>	<p>PROJECT TITLE</p> <p>CONSTRUCTION OF MEN'S FOUR (4) STOREY DORMITORY BUILDING PHASE 1 (AS-BUILT)</p>	<p>DESIGNED FOR:</p>	<p>CHECKED BY:</p> <p>ENGR. CLINTON VAL BRIGOLA PROJECT CONTROL ENGINEER</p>	<p>REVIEWED BY:</p> <p>ENGR. CARLITO A. ELLAZAR PROJECT ENGINEER</p>	<p>CONFORMED BY:</p> <p>REYNALDO B. GARNACE, DA CAD, ADMINISTRATION</p>	<p>RECOMMENDING APPROVAL:</p> <p>DR. EVELYN B. AGUIRRE VP for ADMINISTRATION & FINANCE</p>	<p>APPROVED BY:</p> <p>JUDE A. DUARTE, DPA UNIVERSITY PRESIDENT</p>	<p>SHEET CONTENTS:</p> <p>BAY SECTION</p>	<p>SHEET NO./</p> <p>A 16 16</p>
	<p>IAPOA No.:</p> <p>REG No.:</p> <p>REG DATE:</p> <p>TIN No.:</p>	<p>PTR No.:</p> <p>REG VALID:</p> <p>ISSUED:</p>	<p>LOCATION: TACLOBAN CITY, LEYTE</p>								